

PLAN DRAWN DATE: 07/09/2023 VERSION: 1 SHEET 2 OF 4 SHEETS

NOTE:
JUNCTIONS WERE LOCATED OUTSIDE OF THE DRIVEWAY FOOTPRINT. WHERE DRIVEWAYS WERE LOCATED ON THE DOWNSTREAM SEWER THE JUNCTION WAS INSTALLED 1.0m UPSTREAM OF DRIVEWAY.



1	WORK AS CONSTRUCTED	LBM	07/09/23
No.	AMENDMENT DESCRIPTION	BY	DATE

SEWER LAYOUT PLAN
SCALE 1:1000

WORK AS CONSTRUCTED CERTIFICATION		SYDNEY WATER CORPORATION	
DEVELOPER	LEND LEASE COMMUNITIES (MT. GLEAD) PTY LTD	Sydney WATER	CASE171448WW
W.S.C.	STANTEC (NSW/ACT) PTY LTD		
CONSTRUCTOR	ADAM CRISTOFIDES PLUMBING	SHT 2 OF 4 SHTS.	
COMPLETED	07/09/2023		
W.A.C. PREPARED	09/07/2023		
DESIGNER	STANTEC (NSW/ACT) PTY LTD	SYDNEY WATER CORPORATION	
I CERTIFY THAT THE WORKS HAVE BEEN CONSTRUCTED IN ACCORDANCE WITH THE WORK AS CONSTRUCTED DRAWINGS		FOR DETAILS OF SERVICES SEE SHEET 1	





DEVELOPER CONTRACT PLAN
WORK AS CONSTRUCTED

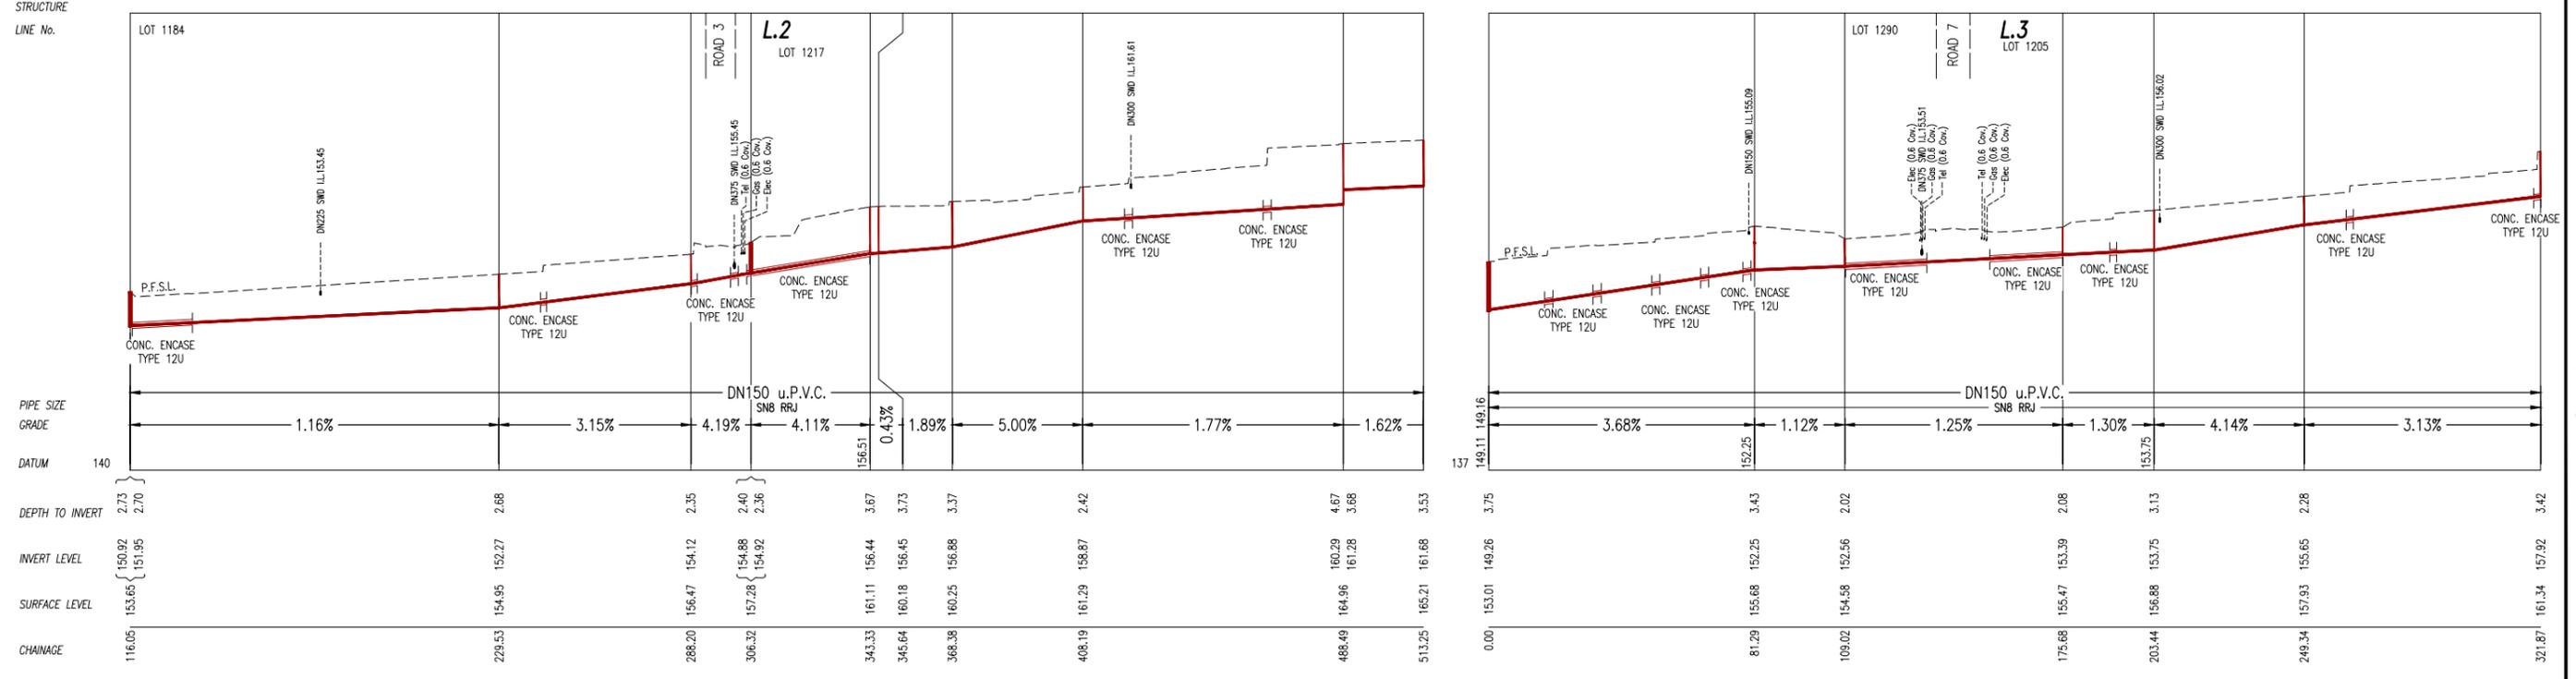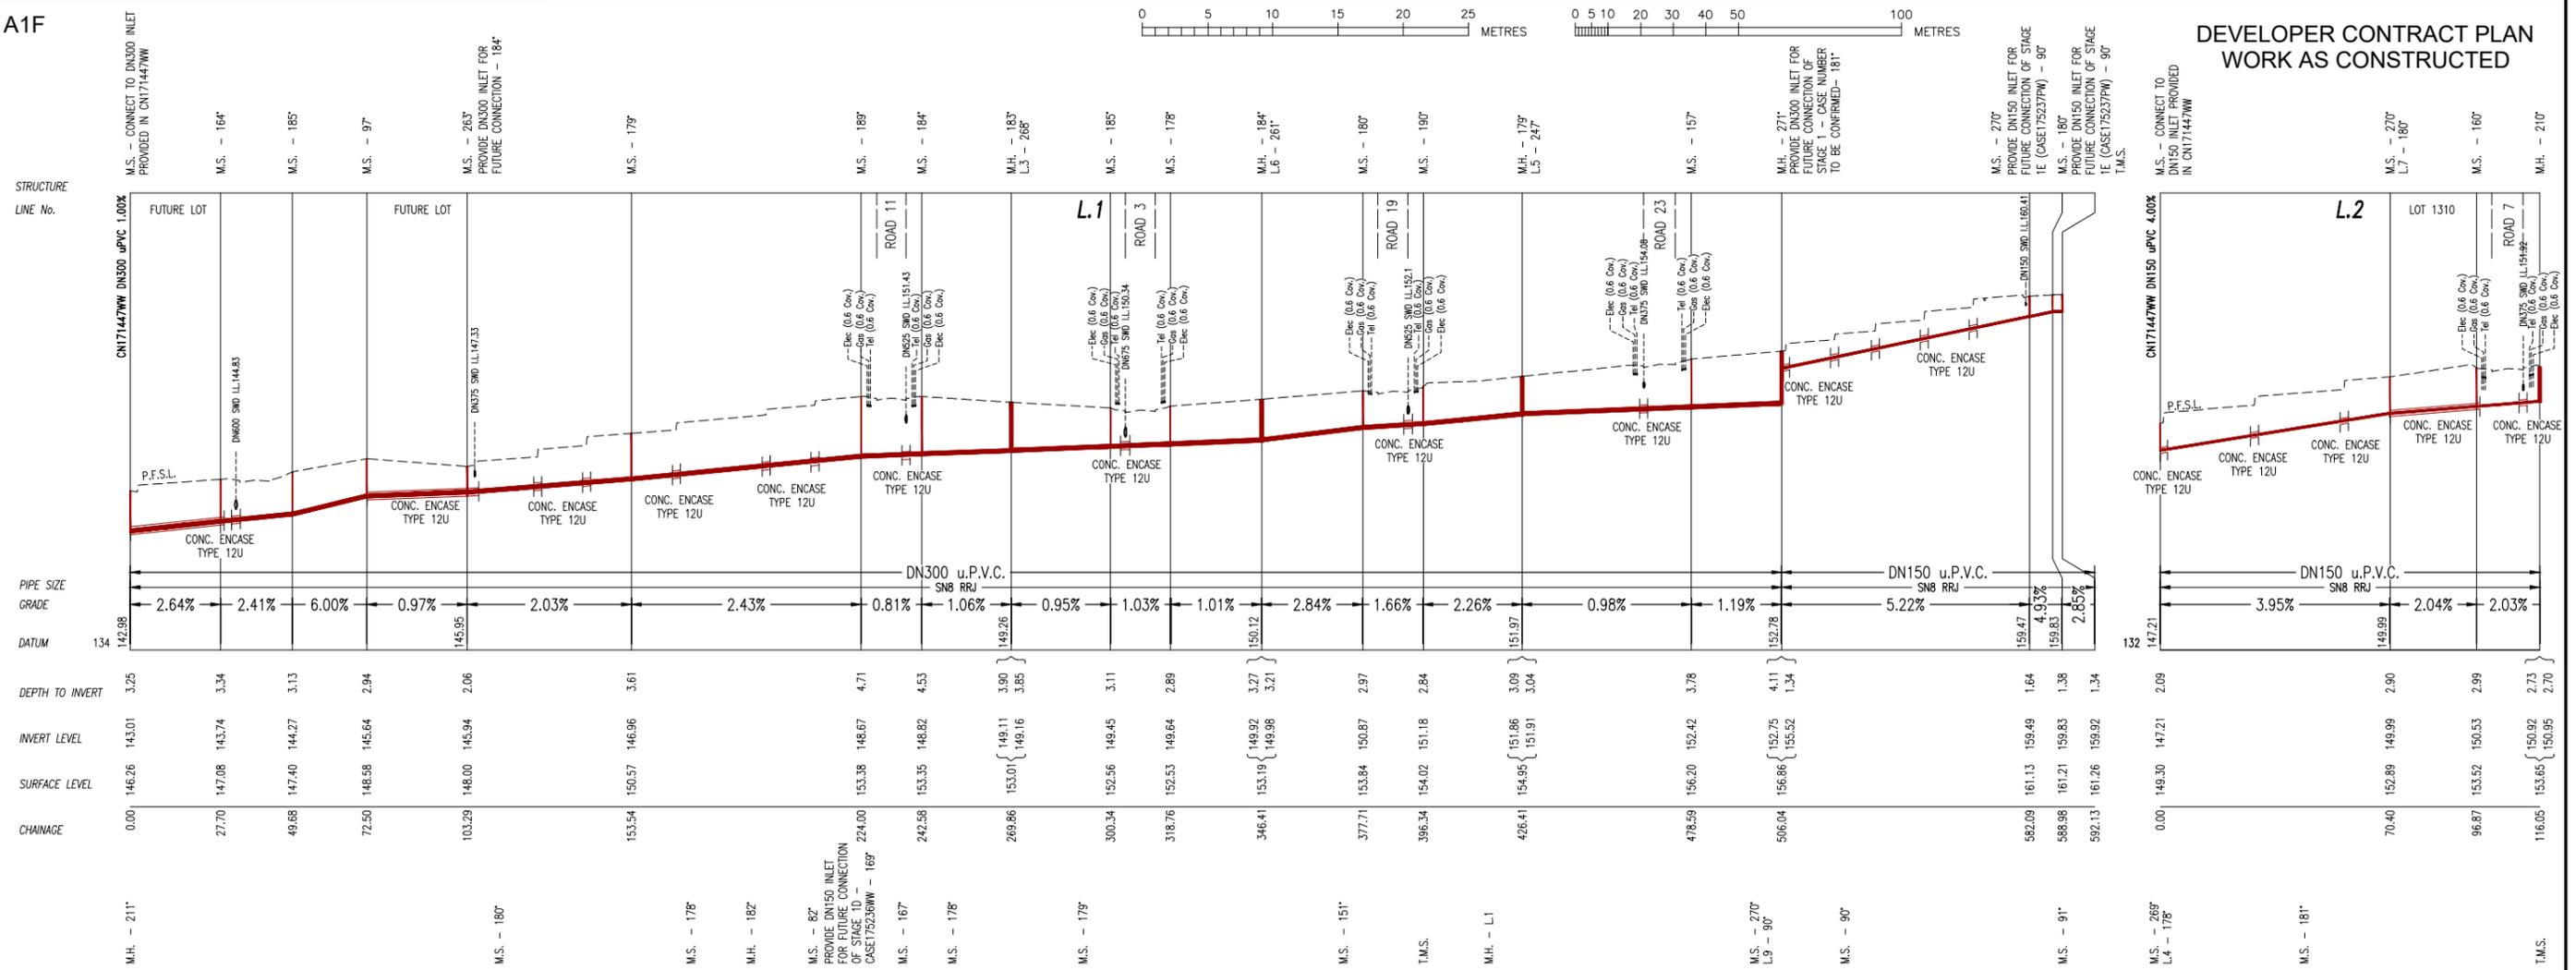

No.	WORK AS CONSTRUCTED	LBM	08/09/23
	AMENDMENT DESCRIPTION	BY	DATE

NOTE:
WHERE THE SEWER WAS ENCASED THE u.P.V.C. MAIN WAS JOINED VIA SOLVENT WELD EXCLUDING THE SECTIONS OF ENCASEMENT UNDER STORMWATER. ENCASEMENT UNDER STORMWATER WAS SNB RRJ JOINED.

WORK AS CONSTRUCTED CERTIFICATION		SYDNEY WATER CORPORATION	
DEVELOPER	LEND LEASE COMMUNITIES (MT. GILEAD) PTY. LTD	Sydney WATER	CASE171448WW
W.S.C.	STANTEC (NSW/ACT) PTY. LTD		
CONSTRUCTOR	ADAM CRISTOFIDES PLUMBING	SHT 3 OF 4 SHTS.	
COMPLETED	07/09/2023		
W.A.C. PREPARED	09/07/2023		
DESIGNER	STANTEC (NSW/ACT) PTY. LTD	SYDNEY WATER CORPORATION	
I CERTIFY THAT THE WORKS HAVE BEEN CONSTRUCTED IN ACCORDANCE WITH THE WORK AS CONSTRUCTED DRAWINGS		FOR DETAILS OF SERVICES SEE SHEET 1	

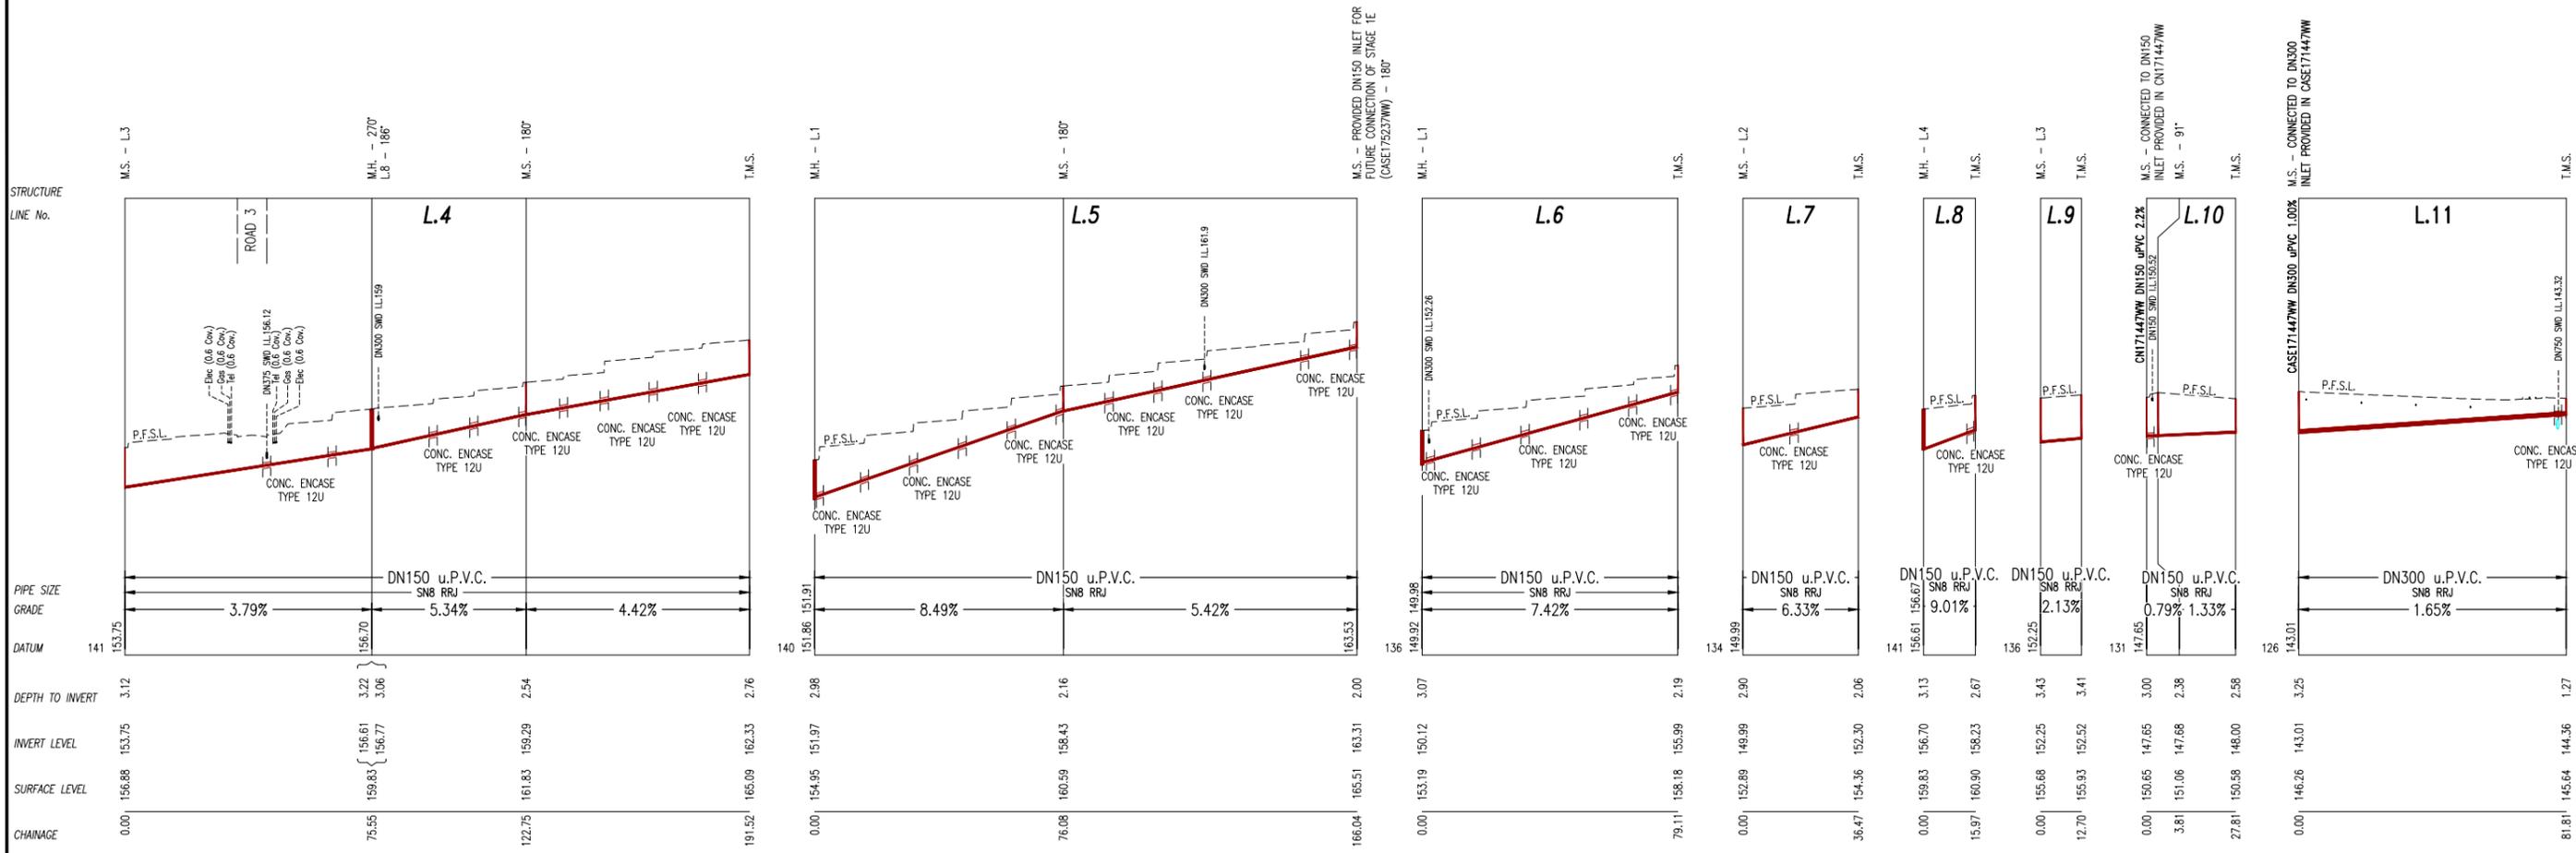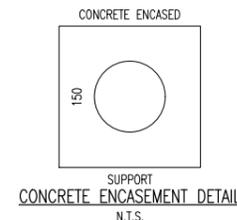

M.S. - PROVIDED DN150 INLET FOR FUTURE CONNECTION OF STAGE 1E (CASE175237WW) - 180°

M.S. - CONNECTED TO DN150 INLET PROVIDED IN CASE171447WW

M.S. - CONNECTED TO DN300 INLET PROVIDED IN CASE171447WW

NOTE:
WHERE THE SEWER WAS ENCASED THE uPVC MAIN WAS JOINED VIA SOLVENT WELD EXCLUDING THE SECTIONS OF ENCASEMENT UNDER STORMWATER. ENCASEMENT UNDER STORMWATER WAS SN8 RRJ JOINED.

1	WORK AS CONSTRUCTED	LBM	07/09/23
No.	AMENDMENT DESCRIPTION	BY	DATE

WORK AS CONSTRUCTED CERTIFICATION		SYDNEY WATER CORPORATION	
DEVELOPER	LEND LEASE COMMUNITIES (MT. GILEAD) PTY. LTD.	Sydney Water	SHT 4 OF 4 SHTS.
W.S.C.	STANTEC (NSW/ACT) PTY. LTD.		
CONSTRUCTOR	ADAM CRISTOFIDES PLUMBING	CASE171448WW	
COMPLETED	07/09/2023		
W.A.C. PREPARED	09/07/2023		
DESIGNER	STANTEC (NSW/ACT) PTY. LTD.	SYDNEY WATER CORPORATION	
I CERTIFY THAT THE WORKS HAVE BEEN CONSTRUCTED IN ACCORDANCE WITH THE WORK AS CONSTRUCTED DRAWINGS		FOR DETAILS OF SERVICES SEE SHEET 1	